

SPECIFICATION OF TREES FOR ORDER NUMBER 4/2012

~~Trees Specified by Reference to an Area (within a dotted black line on the map)~~


Reference on the Map	Description	Situation
A1	Trees (of whatever species) within the Area marked A1 on the map	20 Christchurch Crescent, Radlett, WD7 8AH

TREES SPECIFIED INDIVIDUALLY

<u>REFERENCE ON THE MAP</u>	<u>DESCRIPTION</u>	<u>SITUATION</u>
T1	OAK	20 CHRISTCHURCH CRESC. (FRONT GARDEN, BOUNDARY WITH N° 18A)
T2	OAK	20 CHRISTCHURCH CRESC. (FRONT GARDEN, BOUNDARY WITH HIGHWAY)

TOWN AND COUNTRY PLANNING (TREES) REGULATIONS 2012

Plan referred to in THE HERTSMERE TREE PRESERVATION ORDER (20 Christchurch Crescent, Radlett, WD7 8AH) No 4/2012

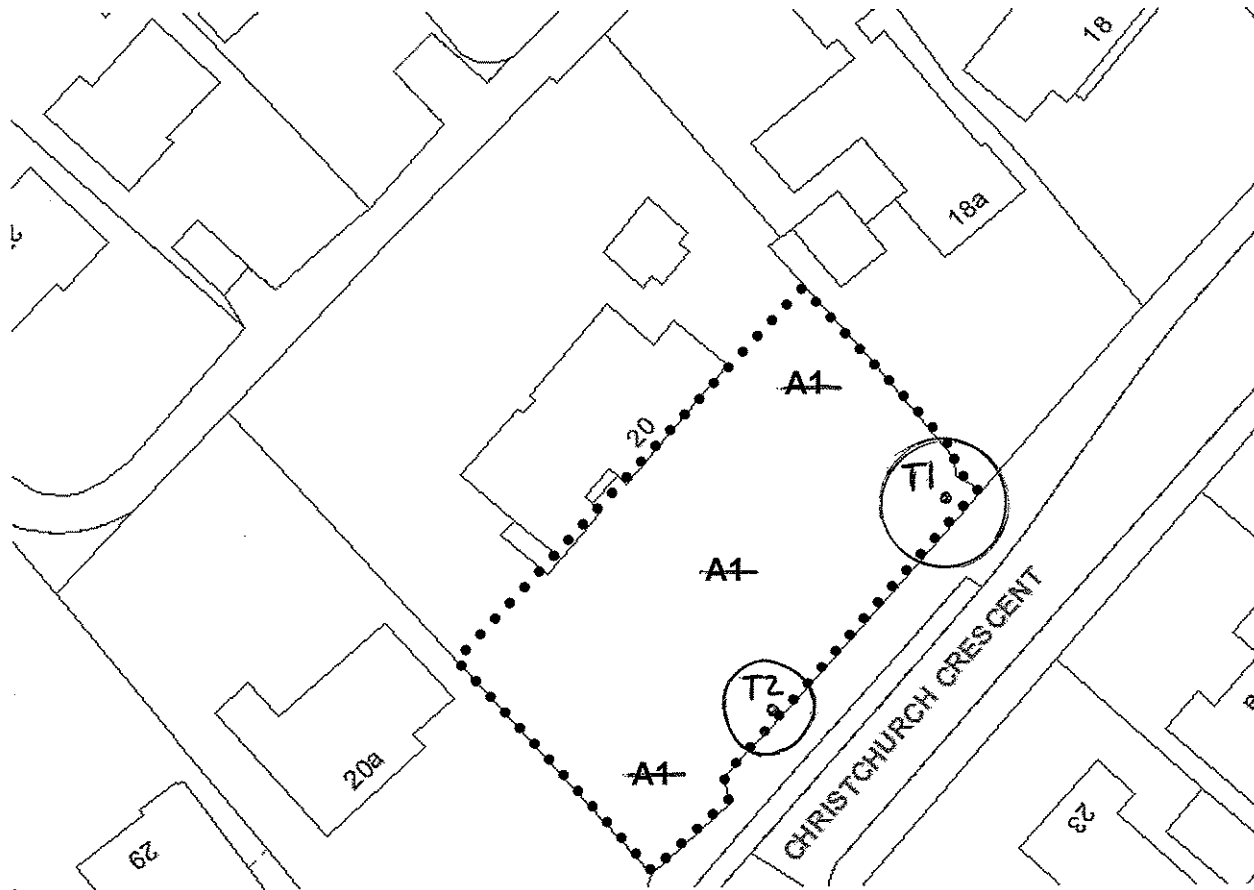

SCHEDULE OF TREES

No Type

~~A1 — Trees (of whatever species) within the Area marked A1 on the map —~~

T1 OAK

T2 OAK

Signed on behalf of Hertsmere Borough Council Eighteenth day of December 2012

Authorised by the Council to sign in that behalf

^{MS} Name and Position: Mark Silverman Policy and Transport Manager

Map Ref:

Hertsmere Borough Council
Civic Offices
Borehamwood
Herts WD6 1WA

SCALE: not to scale DATE: 18/12/2012

DRAWN BY: GJ CHECKED: MS


Reproduced from the Ordnance Survey mapping with the permission of the Controller of Her Majesty's Stationery Office.
© Crown Copyright reserved. Unauthorised reproduction infringes Crown copyright and may lead to prosecution or civil proceedings.

Licence Number LA078239 Hertsmere, 2001.

DRAWING NUMBER: 4/2012

This Order was confirmed by the Hertsmere Borough Council, subject to the modifications indicated on the TPO Plan and Schedule on The Thirteenth day of June 2013

Signed on behalf of the Hertsmere Borough Council

A handwritten signature in black ink, appearing to read 'Mark Silverman', written over the text 'Signed on behalf of the Hertsmere Borough Council'.

MS Mark Silverman

Policy and Transport Manager

Authorised by the Council to sign in that behalf