


# TOWN AND COUNTRY PLANNING (TREES) REGULATIONS 1999

Plan referred to in THE HERTSMERE TREE PRESERVATION ORDER (19 Woodlands Close, Borehamwood, Herts) No 26/2004

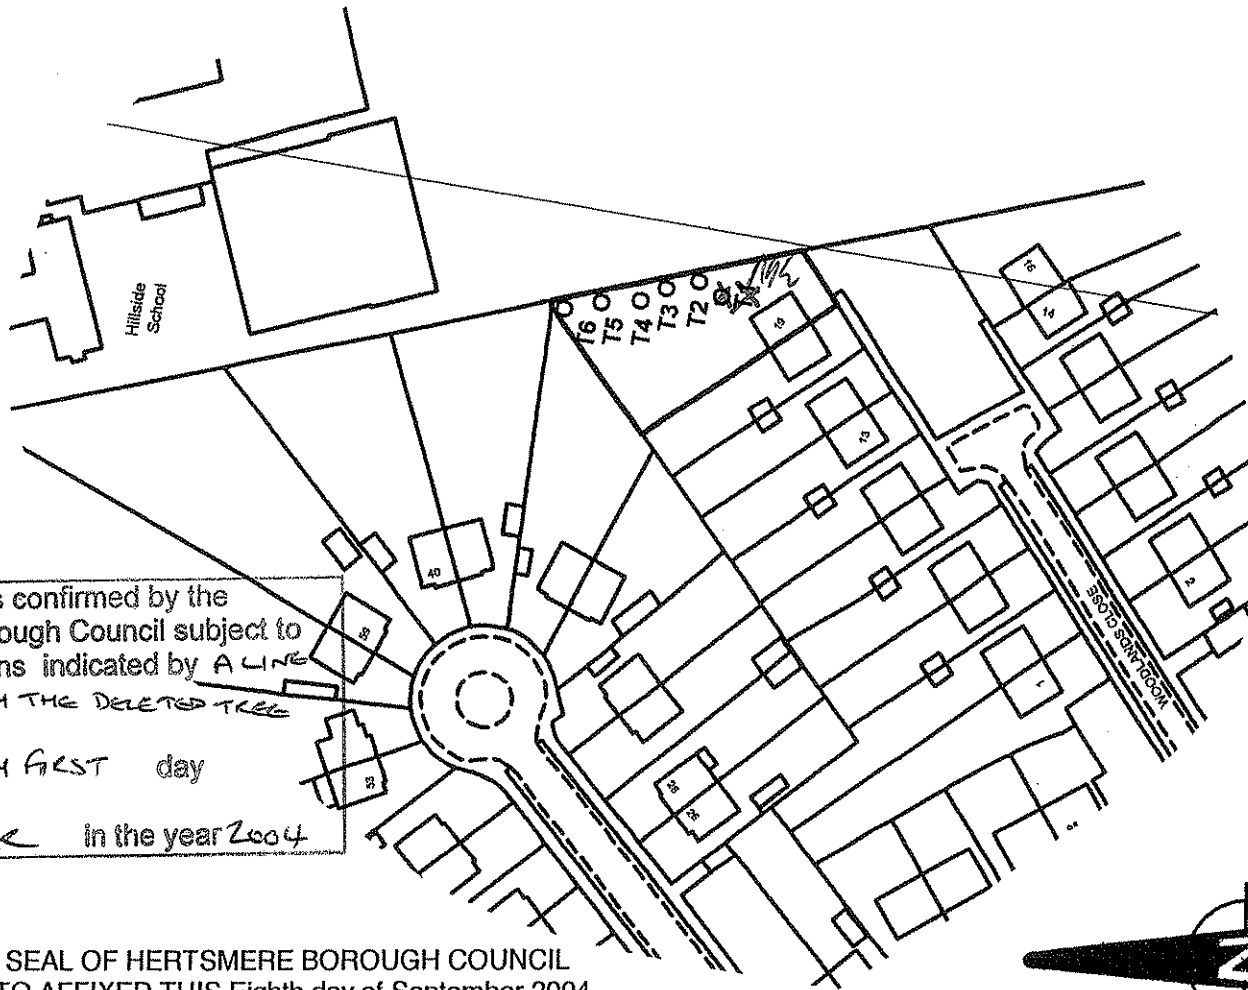

This Order was confirmed by the  
Hertsmere Borough Council subject to  
the modifications indicated by A LINE  
on the TWENTY FIRST day  
of December in the year 2004

THE COMMON SEAL OF HERTSMERE BOROUGH COUNCIL  
WAS HEREUNTO AFFIXED THIS Eighth day of September 2004

IN THE PRESENCE OF:


(Signed) BERYL FOSTER - HEAD OF LEGAL SERVICES

Reproduced from the Ordnance Survey mapping with the permission of the Controller of Her Majesty's Stationery Office.  
© Crown Copyright reserved. Unauthorised reproduction infringes Crown copyright and may lead to prosecution or civil proceedings.  
Licence Number LA078239 Hertsmere, 2001.

## SCHEDULE OF TREES

No Type

<del>T1</del>	<del>Oak</del>
T2	Oak
T3	Oak
T4	Oak
T5	Oak
T6	Oak

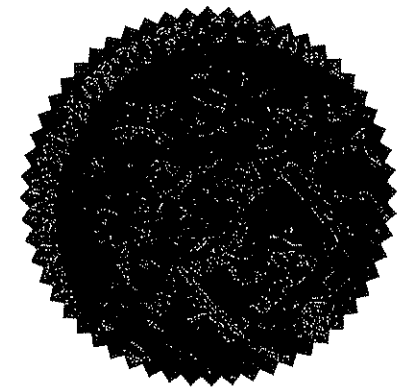

Map Ref: TQ 1998,9635

Hertsmere Borough Council  
Civic Offices  
Borehamwood  
Herts WD6 1WA

SCALE: 1:1250 DATE: 08/09/04

DRAWN BY: SW CHECKED: CH

DRAWING NUMBER: 26/2004