


# TOWN AND COUNTRY PLANNING (TREES) REGULATIONS 1999

Plan referred to in THE HERTSMERE TREE PRESERVATION ORDER (3,4,5 & 7 Watling Knoll, 15The Close and Land to the North of 1 Watling Knoll, Radlett, Herts) No 6/2005

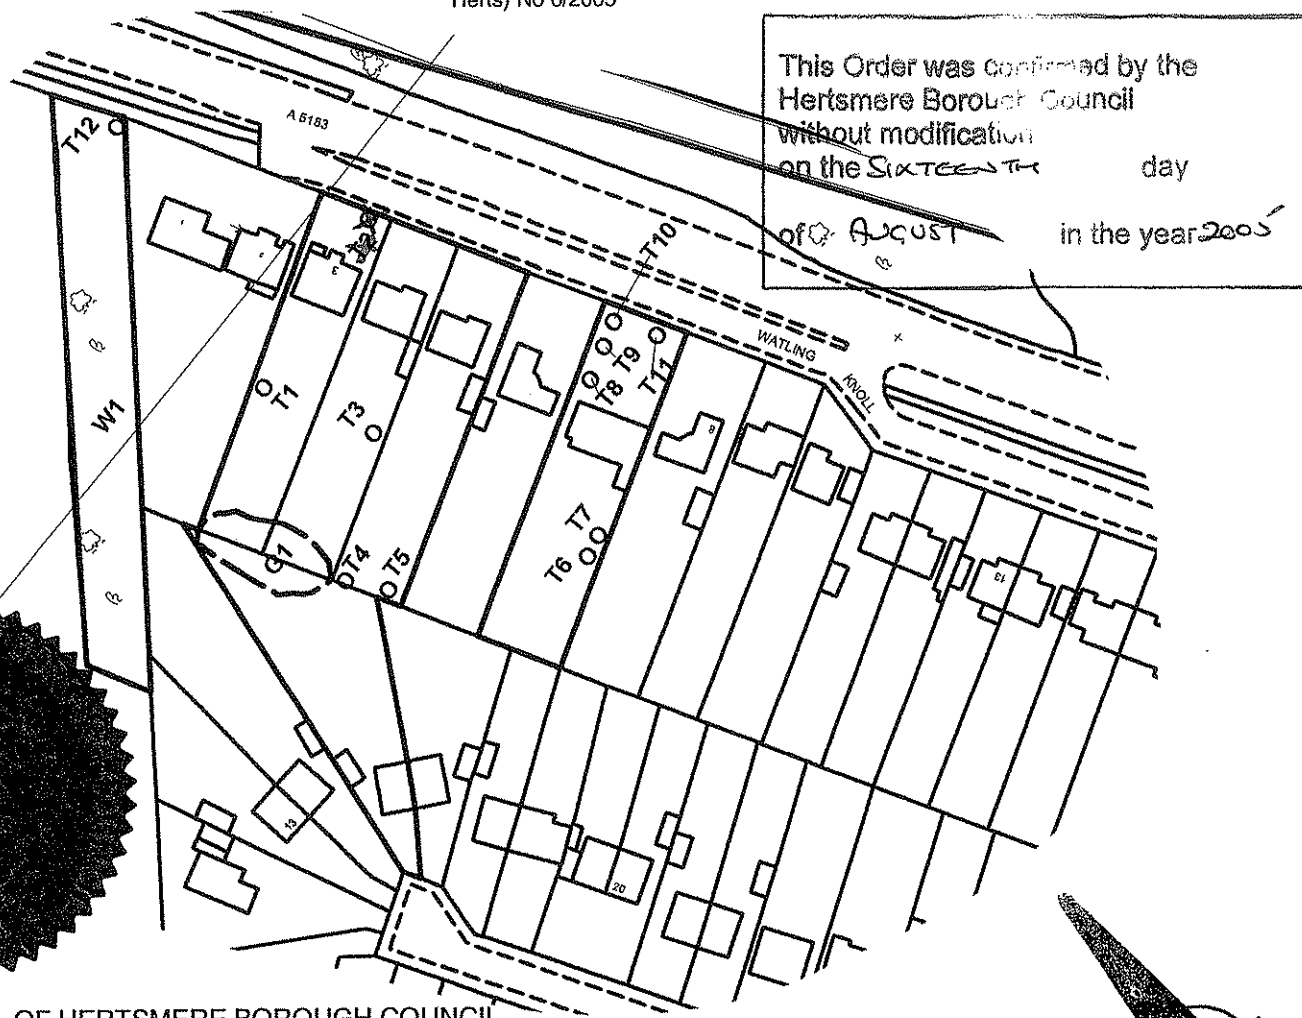

This Order was confirmed by the Hertsmere Borough Council without modification on the SIXTEENTH day of AUGUST in the year 2005

## SCHEDULE OF TREES

No	Type
T1	Birch
<del>T2</del>	<del>Purple Leafed Plum</del> <i>See no 5.9.06</i>
T3	Birch
T4	Beech
T5	Holly
T6	Silver Birch
T7	Purple Leafed Plum
T8	Silver Birch
T9	Silver Birch
T10	Silver Birch
T11	Cherry
T12	Oak
G1	No.2 Cherry, Birch, Hawthorn and Holly
W1	Oak, Ash, Larch, Poplar, Hawthorn, Pine, Sycamore and Field Maple

THE COMMON SEAL OF HERTSMERE BOROUGH COUNCIL WAS HEREUNTO-AFFIXED THIS Seventeenth day of February 2005

IN THE PRESENCE OF:  
*17.10.05 an*  
 (Signed) Authorised Officer

This Order was VARIED by Hertsmere Borough Council as indicated on the Attached Plan.  
 on the FIFTH day of SEPTEMBER in the year 2006

Reproduced from the Ordnance Survey mapping with the permission of the Controller of Her Majesty's Stationary Office. Crown Copyright reserved. Unauthorised reproduction infringes Crown copyright and may lead to prosecution or civil proceedings. Licence Number LA078238 Hertsmere. 2001.

Map Ref: TL 1589,0097	
Hertsmere Borough Council Civic Offices Borehamwood Herts WD6 1WA	
SCALE: 1:1250	DATE: 17/02/2005
DRAWN BY: SW	CHECKED <i>ROK</i>
DRAWING NUMBER: 6/2005	