TOWN AND COUNTRY PLANNING (TREES) REGULATIONS 1999

Plan referred to in THE HERTSMERE TREE PRESERVATION ORDER (73 The Causeway & verge adjacent to 75 The Causeway, 7, 38 and verge at Bearwood Close and 2 The Spinney, Potters Bar, Herts) No 5/2008

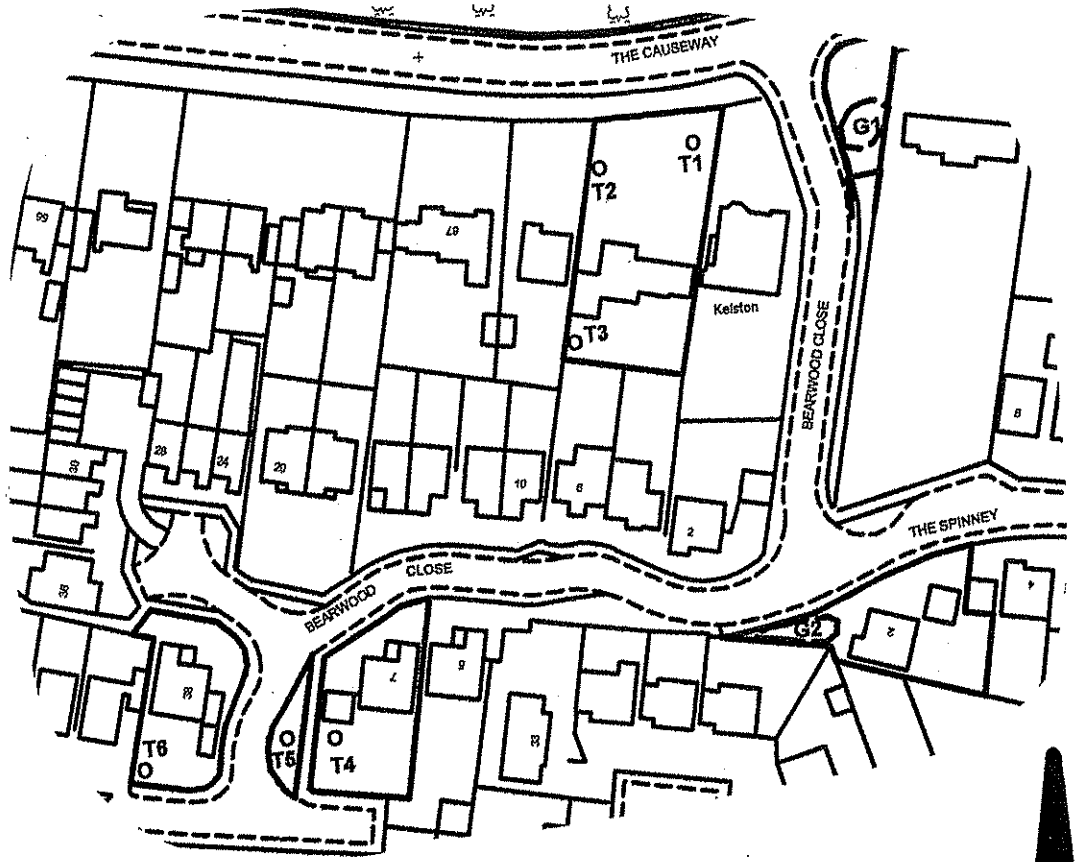

SCHEDULE OF TREES

No	*Type*
T1	Oak
T2	Oak
T3	Oak
T4	Pine
T5	Cedar
T6	Silver Birch
G1	2 no. Oak
G2	~~2 no Firs~~, 1 no. Oak
G2	1 no DOUGLAS FIR
~~G2~~	~~1 no. DOUGLAS FIR~~ removed

This Order was confirmed by the Hertsmere Borough Council subject to the modifications indicated by REMOVAL OF DOUGLAS FIR NEAREST HOUSE IN G2 & CHANGE OF NAME FROM FIR TO DOUGLAS FIR IN G2 on the SIXTH day of NOVEMBER in the year 2008.

THE COMMON SEAL OF HERTSMERE BOROUGH COUNCIL WAS HEREUNTO AFFIXED THIS Twenty Second day of January 2008

IN THE PRESENCE OF:

(Signed) Interim Head of Legal Services

Reproduced from the Ordnance Survey mapping with the permission of the Controller of Her Majesty's Stationery Office. © Crown Copyright reserved. Unauthorised reproduction infringes Crown copyright and may lead to prosecution or civil proceedings. Licence Number LA078239 Hertsmere. 2001.

Map Ref: TL 2665,0157

Hertsmere Borough Council
Civic Offices
Borehamwood
Herts WD6 1WA

SCALE: 1:1250 DATE: 22/01/2008

DRAWN BY: SW CHECKED MS

DRAWING NUMBER: 5/2008